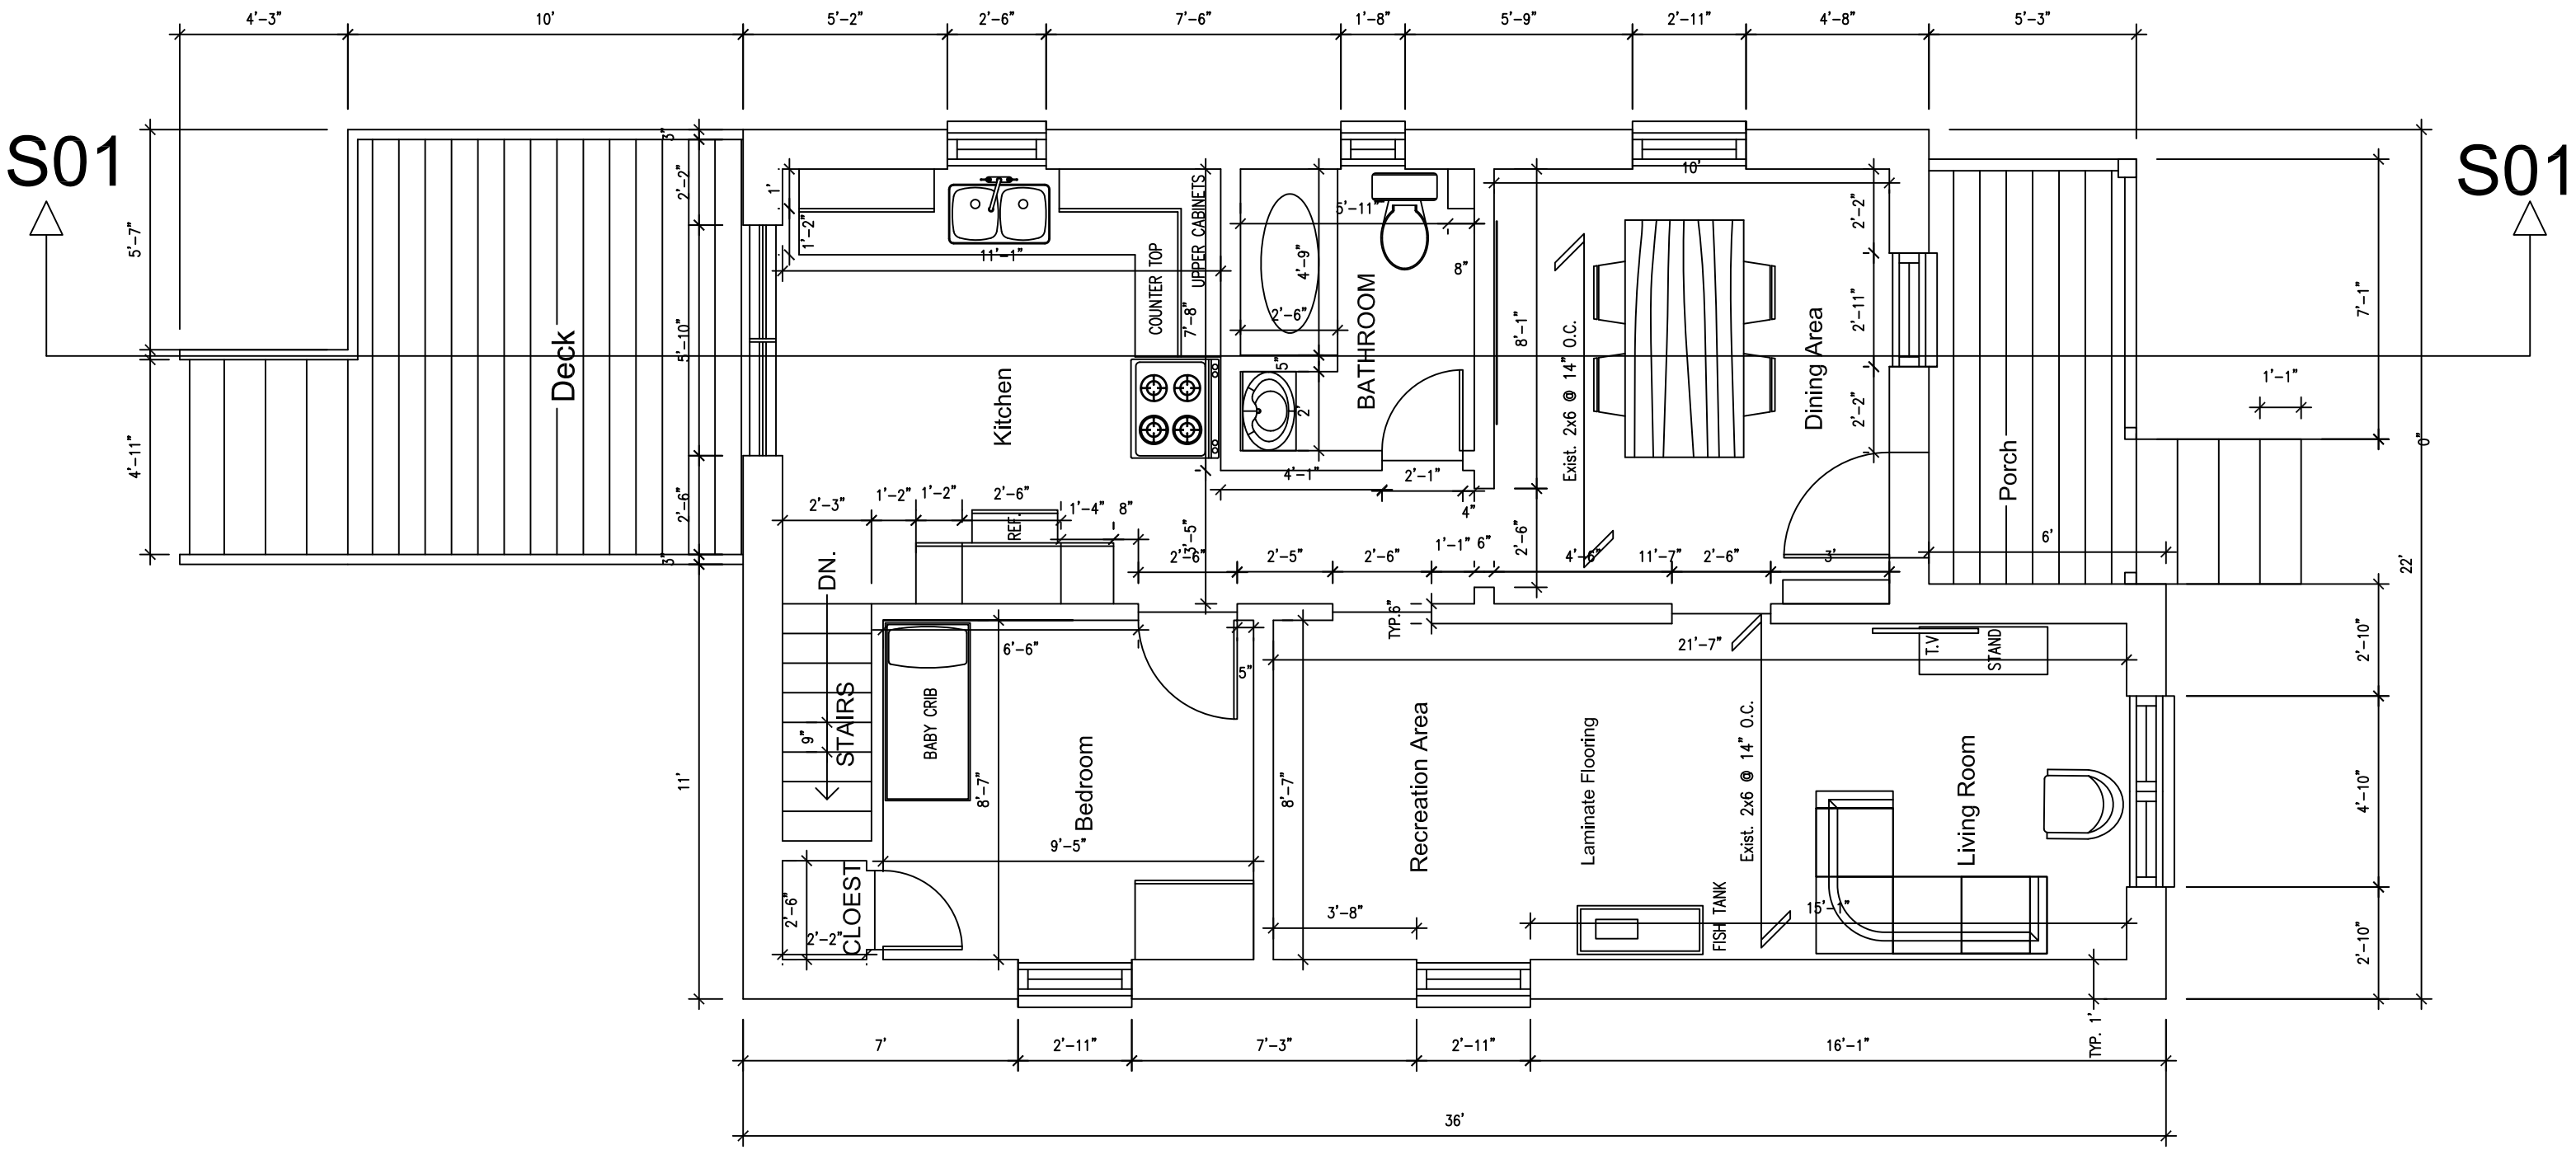

1

AS-BUILT GROUND FLOOR PLAN

1/4"=1'0"

TRUE NORTH	CONSTR. NORTH	DATE:	PROJECT NO:	PROJECT NAME:	DRAWN BY:	DWG. TITLE.:	SCALE:	DWG. No.:
		NOV/14/2013	ASSIGNMENT 3: PROGRAM & AS-BUILT DRAWINGS	FEINWAX RESIDENCE	JOSE AMBROSIO LUIS PLANA	AS BUILT 1ST FLOOR PLAN	AS NOTED: REVISION No.: -	A-1